


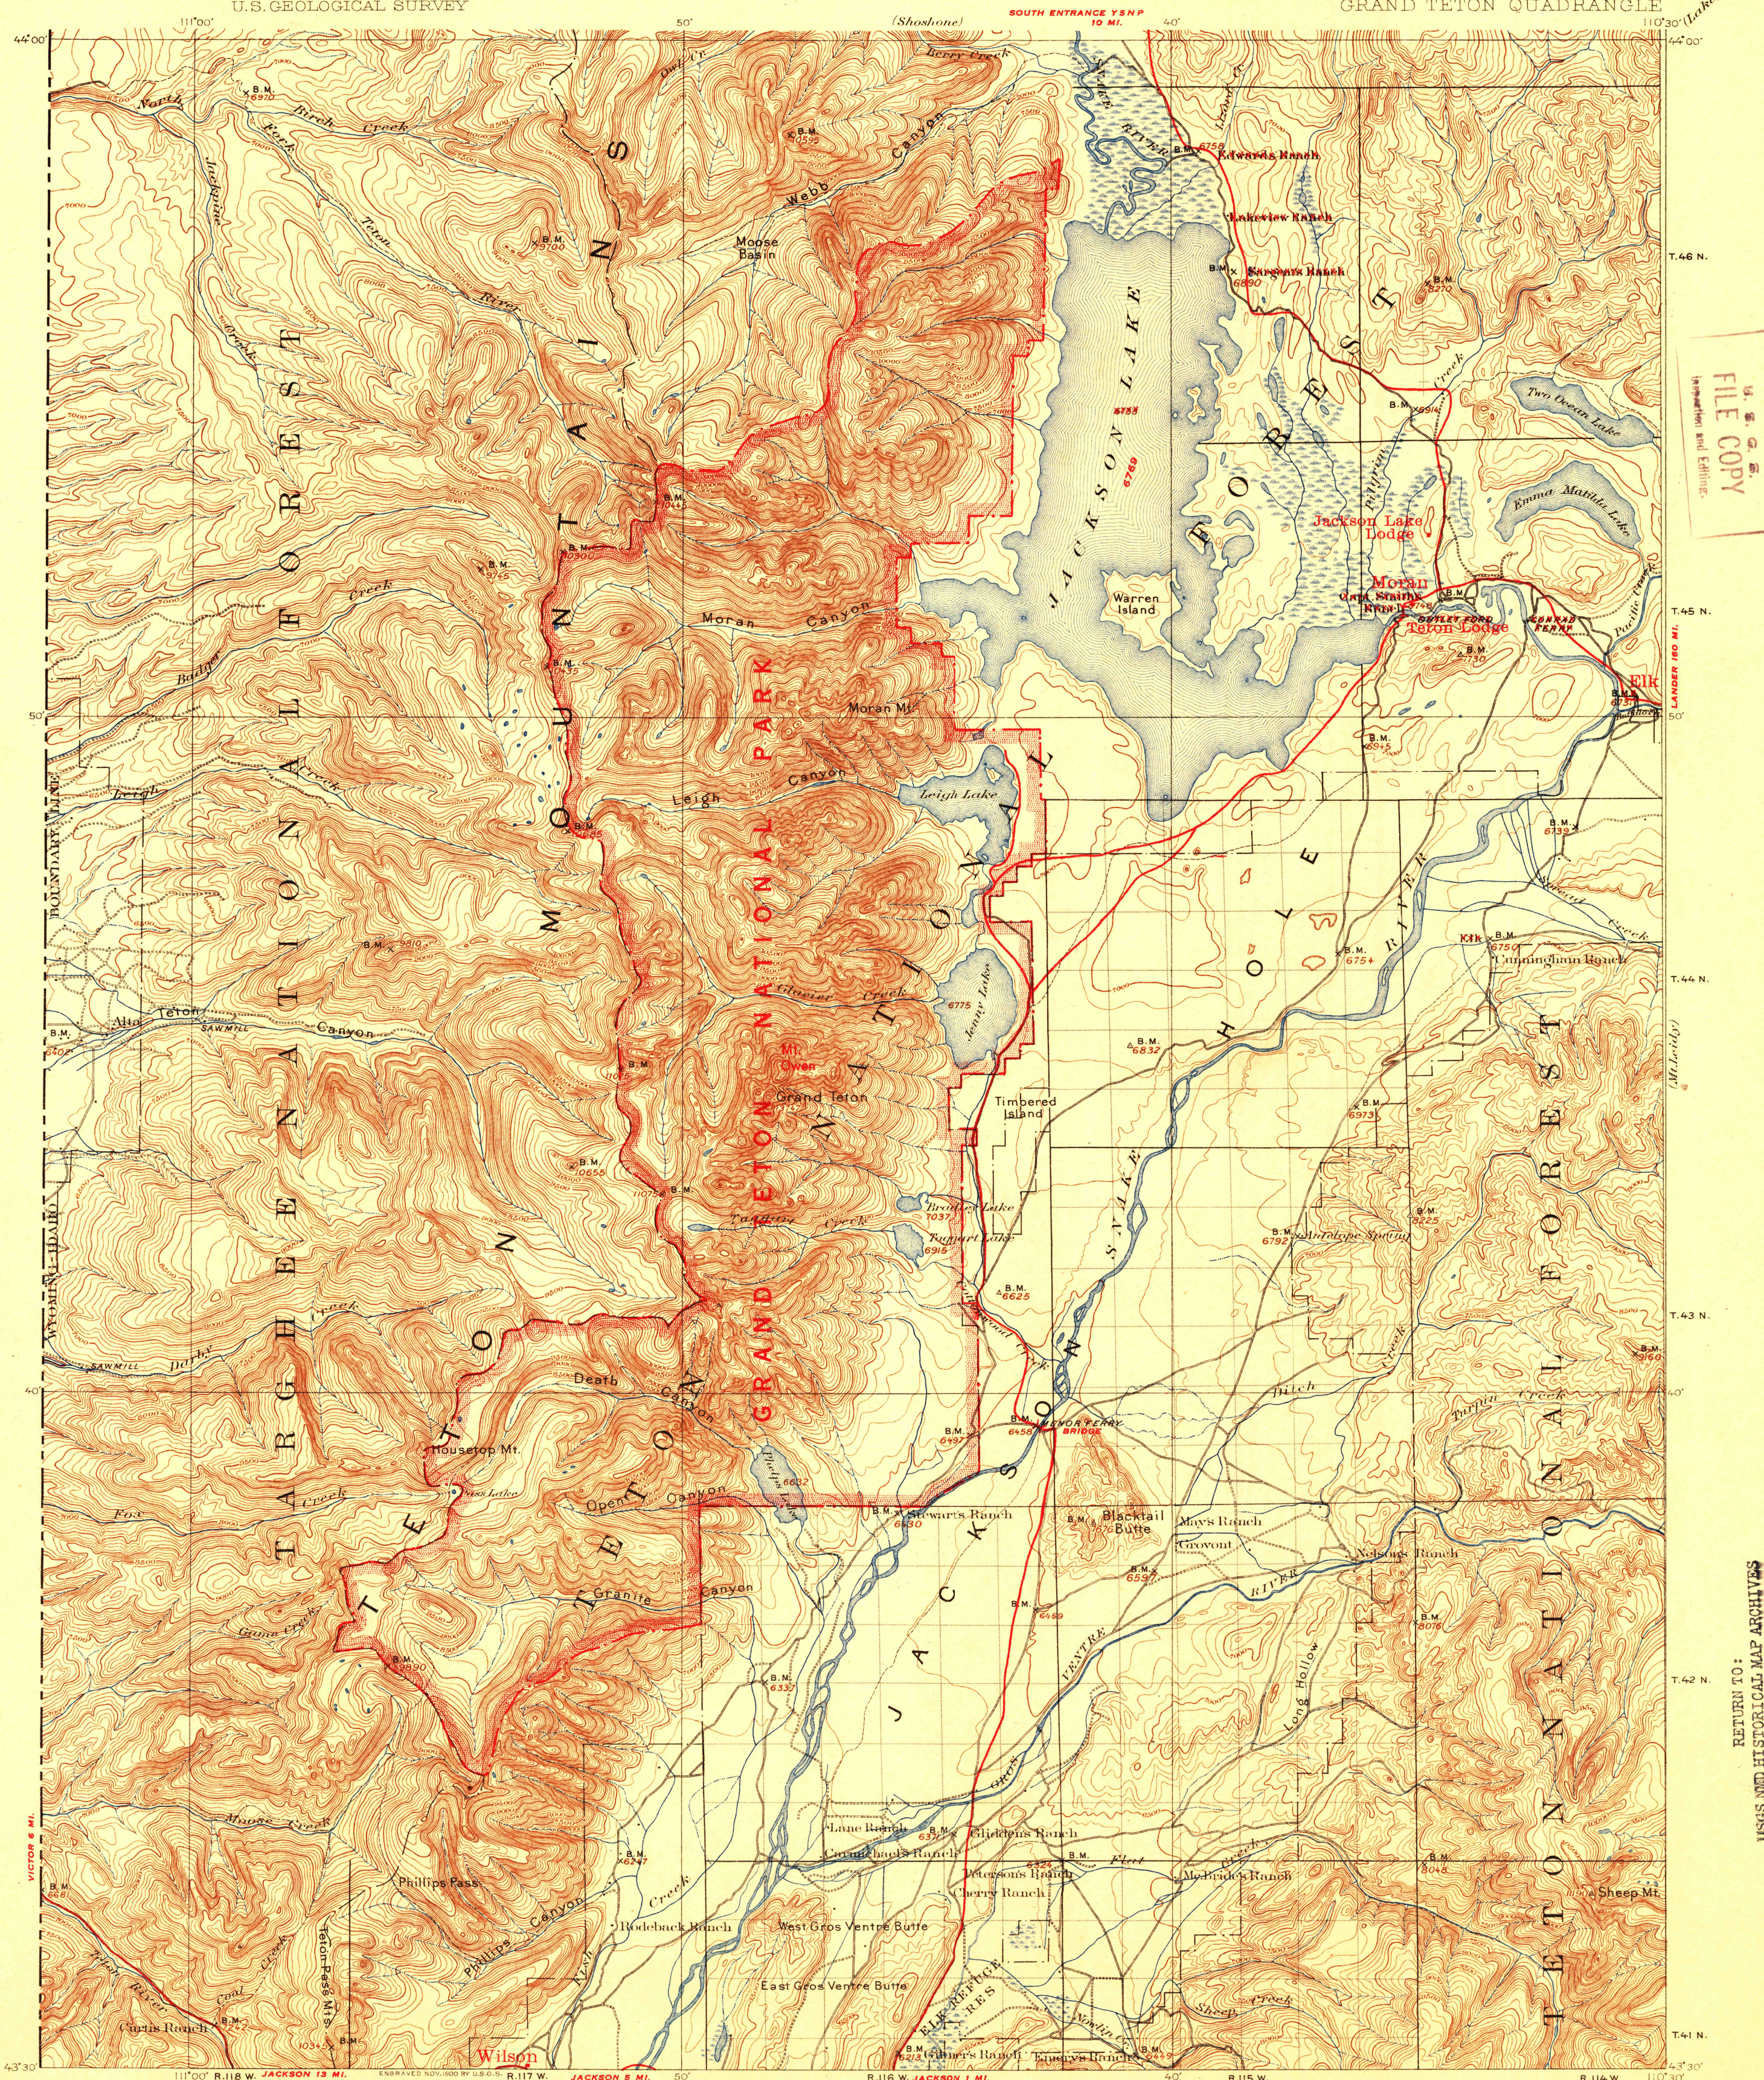

U. S. G. S.
FILE COPY
Inspection and Editing.

RETURN TO:
USGS AND HISTORICAL MAP ARCHIVES

111°00' R. 118 W. JACKSON 13 MI.
E. M. Douglas, Geographer in charge.
Triangulation by T. M. Bannon.
Topography by T. M. Bannon and Arthur Stiles.
Surveyed in 1899.

U. S. G. S.
FILE COPY
Inspection and Editing.

Scale 1:25,000
1 2 3 4 5 Miles
1 2 3 4 5 Kilometers
Contour interval 100 feet.
Datum is mean sea level.

Main roads, names, and other
information shown in red added
by National Park Service, 1929.
National Park area eliminated
from Teton National Forest.

Edition of April 1901, reprinted 1923.

GRAND TETON
MAY 13 1929 (1525) WYO

Note: The elevations shown on this map are based upon
preliminary levels by the Burlington and Missouri River R.R. Co.